

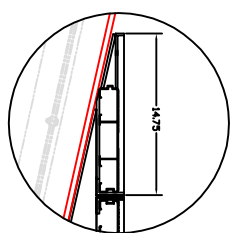
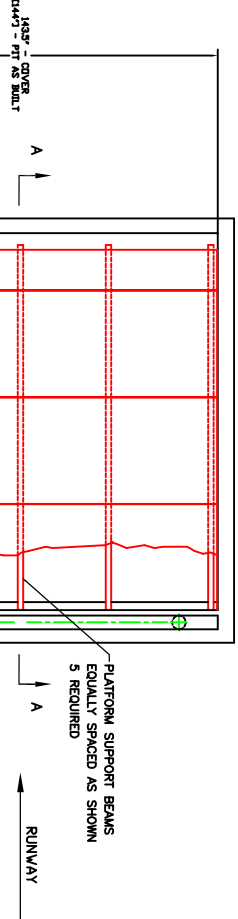



REV	DESCRIPTION	DATE	APPROVED
1			

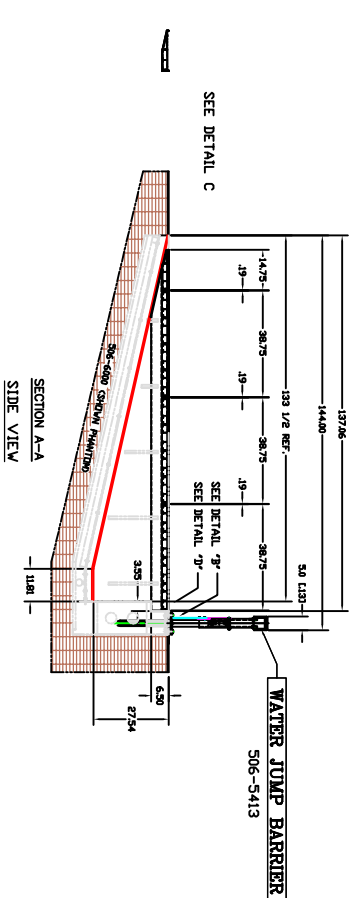



DETAIL C SCALE: 4X

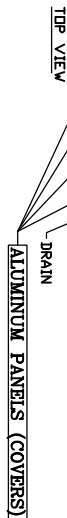

SECTION A-A  
SIDE VIEW

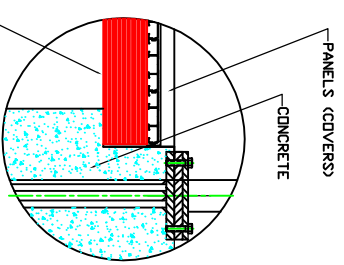

DETAIL D SCALE: 4 X

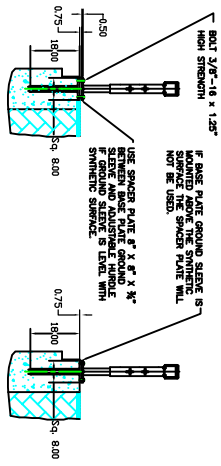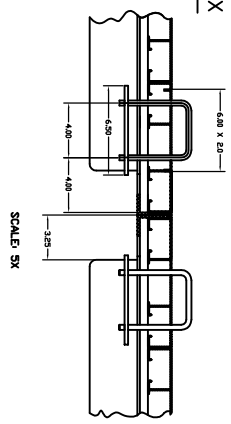

WEIGHT: ONE - COMPLETED UNIT  
POUNDS: 660

ASSEMBLED

DIMENSIONS IN [...] ARE PER CUSTOMER MEASUREMENTS IN FIELD (AS BUILT)

NO.	REVISION	REV STATUS
1		

**UCSS** 800-526-4866 www.ucsspitt.com

511 HOFFMAN RD.  
LINCOLN, N.C. 28092

UNLESS OTHERWISE SPECIFIED  
DIMENSIONS ARE IN INCHES  
3 PLACES ±.10  
2 PLACES ±.010  
1 PLACE ±.005

APPROVALS: DATE TITLE  
DESIGNED BY WATER JUMP PIT COVER  
CHECKED BY RECESSED  
SCALE: 1/2"=1'

DATE FILE 506-5420  
DWG NO. 506-5420  
SHEET 2 OF 4