


REV	DESCRIPTION	DATE	APPROVED

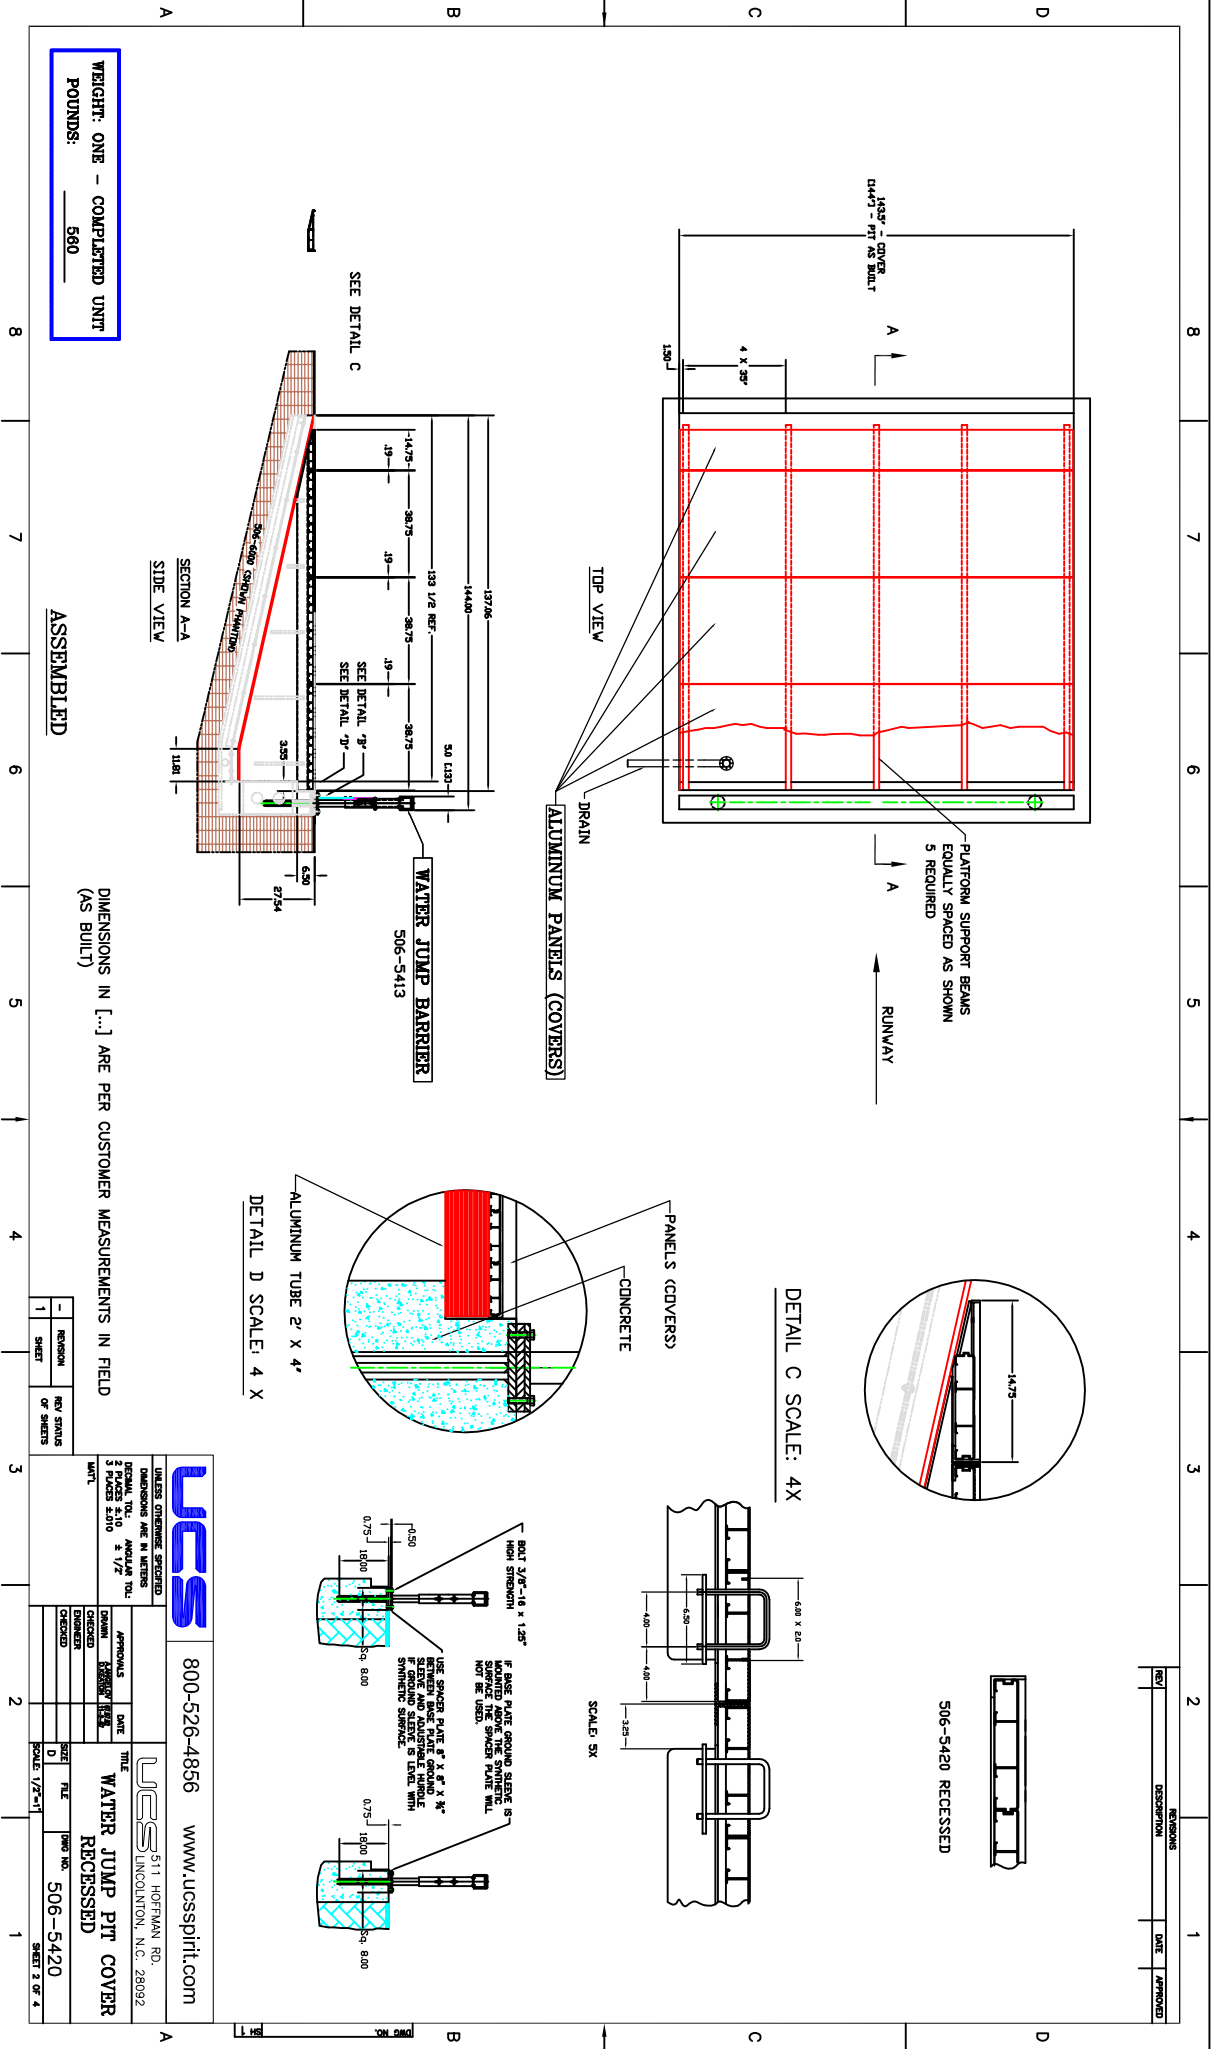

WEIGHT: ONE - COMPLETED UNIT  
POUNDS: 560

ASSEMBLED

DIMENSIONS IN [...] ARE PER CUSTOMER MEASUREMENTS IN FIELD (AS BUILT)

REV	REVISION	REV STATUS
1	SHEET	OF SHEETS

**UCSS** 800-526-4866 www.ucsspitt.com

511 HOFFMAN RD. LINCOLN, N.C. 28092

UNLESS OTHERWISE SPECIFIED, DIMENSIONS ARE IN INCHES. DETAIL TOL. ANGLE TOL. 3 PLACES ±.10 ± 1/2" W/RT.

APPROVALS	DATE	TITLE
DRAWN		WATER JUMP PIT COVER
CHECKED		RECESSED
SCALE	FILE	506-5420
SCALE	1/2"=1'	SHEET 2 OF 4