


REV	DESCRIPTION	DATE	APPROVED

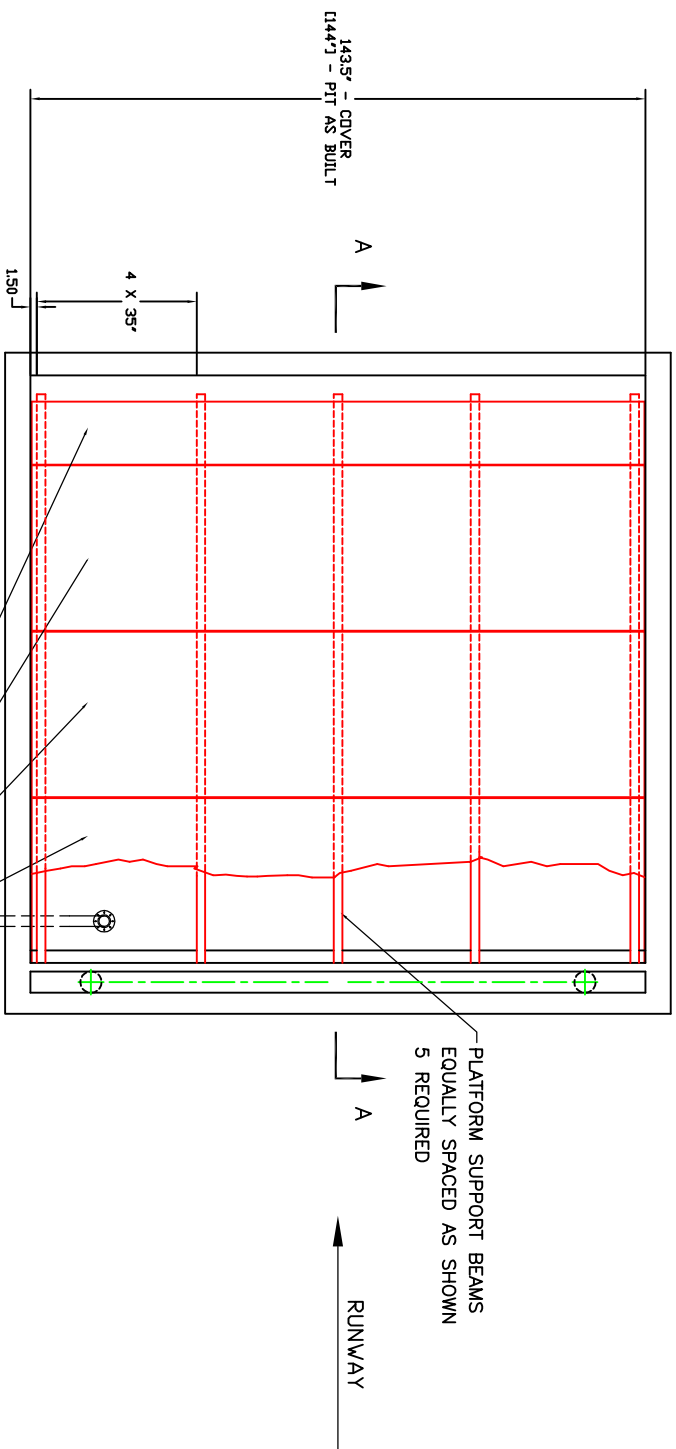

PLATFORM SUPPORT BEAMS  
EQUALLY SPACED AS SHOWN  
5 REQUIRED

1435' COVER  
E447J - PIT AS BUILT

TOP VIEW  
DRAIN  
ALUMINUM PANELS (COVERS)


A  
RUNWAY

A


A

A


A

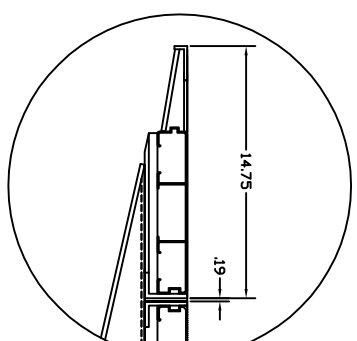


DETAIL C SCALE: 4X

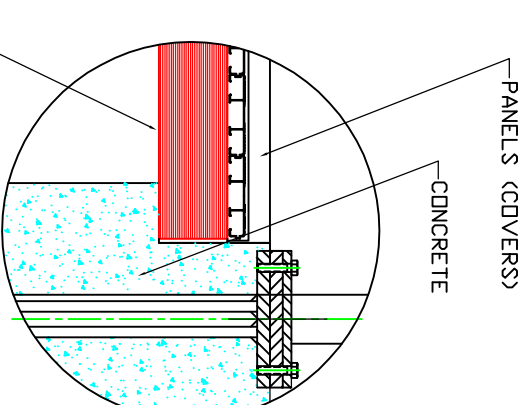

DETAIL D SCALE: 4 X

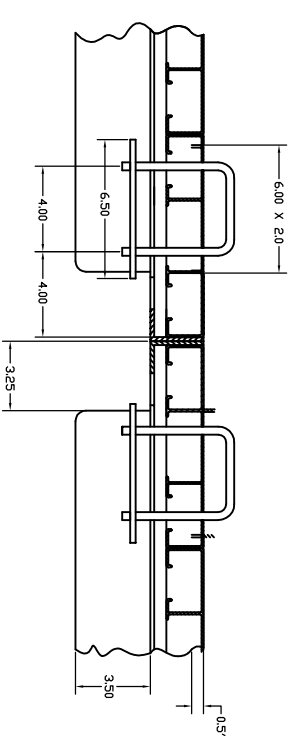


SCALE: 5X

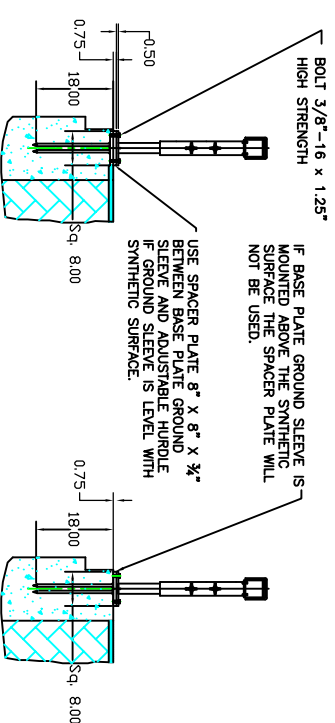

BOLT 3/8"-16 x 1.25"  
HIGH STRENGTH

IF BASE PLATE GROUND SLEEVE IS MOUNTED ABOVE THE SYNTHETIC SURFACE THE SPACER PLATE WILL NOT BE USED.

USE SPACER PLATE 8" X 8" X 3/4" BETWEEN BASE PLATE GROUND SLEEVE AND SLEEVE IF GROUND SLEEVE IS LEVEL WITH SYNTHETIC SURFACE.

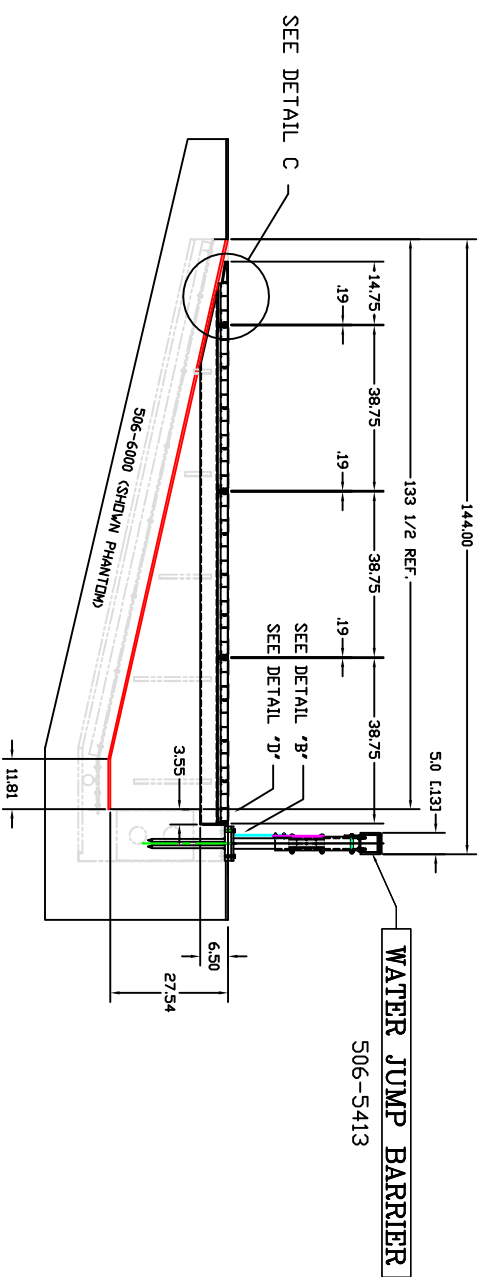

SECTION A-A  
SIDE VIEW

ASSEMBLED

DIMENSIONS IN [...] ARE PER CUSTOMER MEASUREMENTS IN FIELD  
(AS BUILT)

WEIGHT: ONE - COMPLETED UNIT  
POUNDS: 560

**UCSS** 800-526-4856 www.ucsspirit.com  
5111 HOFFMAN RD. LINCOLNTON, N.C. 28092

UNLESS OTHERWISE SPECIFIED DIMENSIONS ARE IN METERS	APPROVALS	DATE	TITLE
DECIMAL TOL: ANGULAR TOL:	DRAWN	DATE	WATER JUMP PIT COVER
3 PLACES ±.00 ± 1/2	CHECKED	DATE	NON RECESSED
MATL	ENGINEER	DATE	
	CHECKED	DATE	

REVISION	REV STATUS
1 SHEET	OF SHEETS

SIZE	FILE	DWG NO.
D		506-5421
SCALE: 1/2"=1'		SHEET 2 OF 4

A

B

C

D

8

7

6

5

4

3

2

1

A

B

C

D