

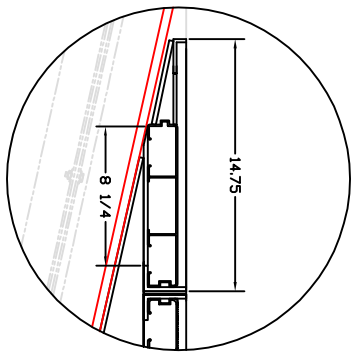


REV	DESCRIPTION	DATE	APPROVED

REV	DESCRIPTION	DATE	APPROVED

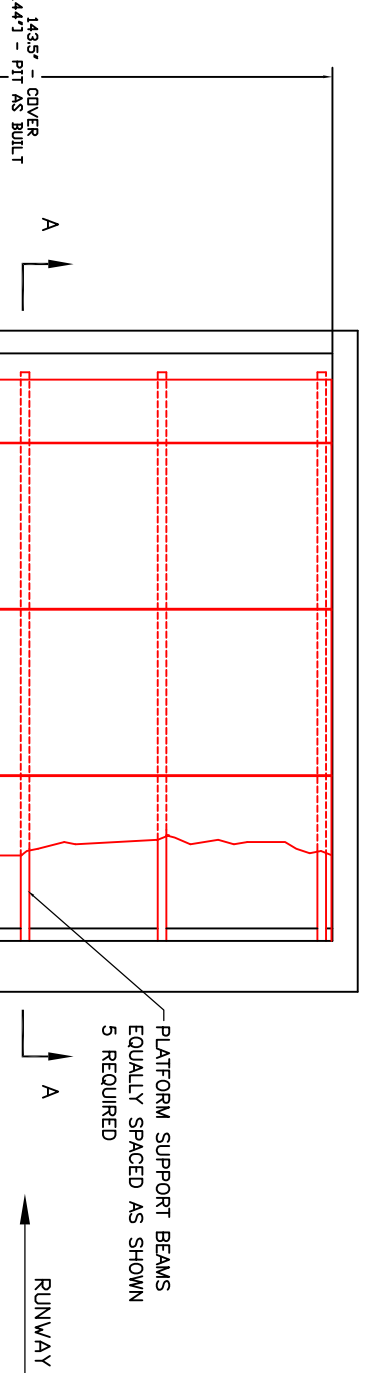


DETAIL C SCALE: 4X

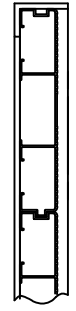

506-5420 RECESSED


TOP VIEW
ALUMINUM PANELS (COVERS)

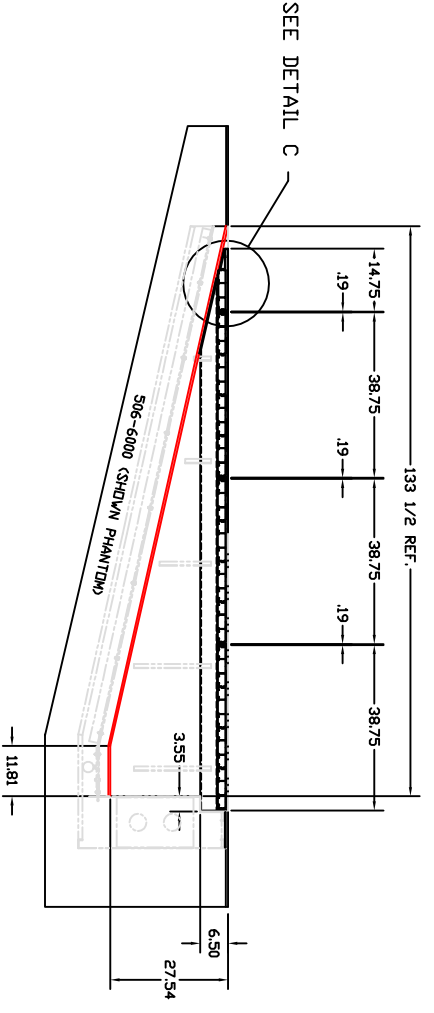


SECTION A-A
SIDE VIEW

ASSEMBLED

DIMENSIONS IN [...] ARE PER CUSTOMER MEASUREMENTS IN FIELD (AS BUILT)

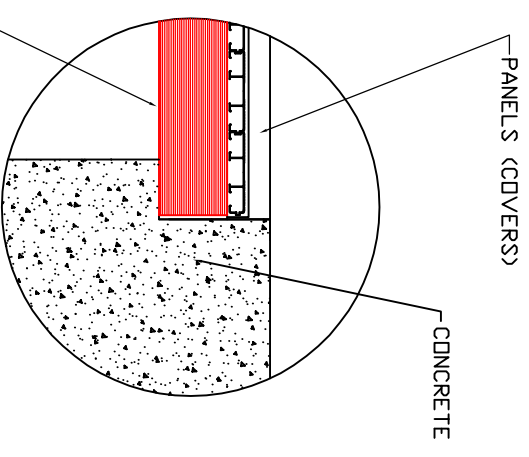


DETAIL D SCALE: 4 X

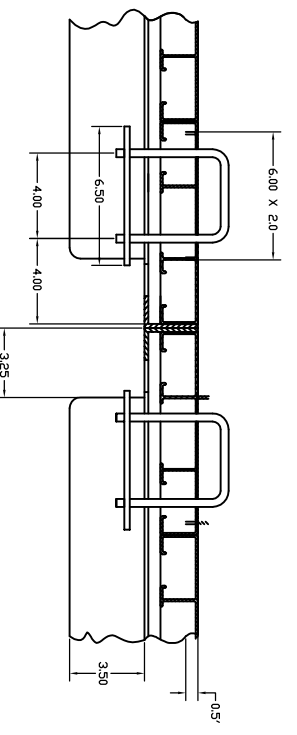

SCALE: 5X

WEIGHT: ONE - COMPLETED UNIT
POUNDS: 560

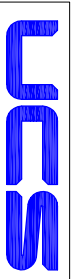

800-526-4856 www.ucsspirit.com

UNLESS OTHERWISE SPECIFIED
DIMENSIONS ARE IN METERS

DECIMAL TOL: ANGULAR TOL:
3 PLACES ±.010 ± 1/2
MATT

APPROVALS	DATE	TITLE
DRAWN		ALUMINUM WATER JUMP
CHECKED		PIT FORM WITH COVERS
ENGINEER		
CHECKED		

REVISION	REV STATUS
1 SHEET	OF SHEETS

SIZE	FILE	DWG NO.
D		506-6420

SHEET 2 OF 4